

ELEVATION CERTIFICATE

OMB No. 1660-0008
Expires February 28, 2009

Important: Read the instructions on pages 1-8.

| SECTION A - PROPERTY INFORMATION | | For Insurance Company Use: |
|--|---|---|
| A1. Building Owner's Name <u>ELIZABETH ANG</u> | | Policy Number |
| A2. Building Street Address (including Apt., Unit, Suite, and/or Bldg. No.) or P.O. Route and Box No. <u>5113 HASKELL AVE.</u> | | Company NAIC Number |
| City <u>LOS ANGELES,</u> | State <u>CA.</u> | ZIP Code <u>91436</u> |
| A3. Property Description (Lot and Block Numbers, Tax Parcel Number, Legal Description, etc.) <u>LOT 12 TRACT NO. 13281, M.B. 320-21</u> | | |
| A4. Building Use (e.g., Residential, Non-Residential, Addition, Accessory, etc.) <u>ACCESSORY (GARAGE W/LIVING QUARTERS ABOVE)</u> | | |
| A5. Latitude/Longitude: Lat. <u>34° 09.49' N</u> Long. <u>118° 28.29' W.</u> | | Horizontal Datum: <input type="checkbox"/> NAD 1927 <input checked="" type="checkbox"/> NAD 1983 |
| A6. Attach at least 2 photographs of the building if the Certificate is being used to obtain flood insurance. | | |
| A7. Building Diagram Number <u>#1</u> | | |
| A8. For a building with a crawl space or enclosure(s), provide: | | A9. For a building with an attached garage, provide: |
| a) Square footage of crawl space or enclosure(s) <u>0</u> sq ft | b) No. of permanent flood openings in the crawl space or enclosure(s) walls within 1.0 foot above adjacent grade <u>0</u> | a) Square footage of attached garage <u>897</u> sq ft |
| c) Total net area of flood openings in A8.b <u>0</u> sq in | | b) No. of permanent flood openings in the attached garage walls within 1.0 foot above adjacent grade <u>0</u> |
| | | c) Total net area of flood openings in A9.b <u>0</u> sq in |

SECTION B - FLOOD INSURANCE RATE MAP (FIRM) INFORMATION

| | | | | | |
|--|------------------------|---|--|--------------------------------|---|
| B1. NFIP Community Name & Community Number <u>CITY OF LOS ANGELES - 060137</u> | | B2. County Name <u>LOS ANGELES</u> | | B3. State <u>CA</u> | |
| B4. Map/Panel Number <u>060137-0038</u> | B5. Suffix <u>C</u> | B6. FIRM Index Date <u>5/04/1999</u> | B7. FIRM Panel Effective/Revised Date <u>12/02/80</u> | B8. Flood Zone(s) <u>AH</u> | B9. Base Flood Elevation(s) (Zone AO, use base flood depth) <u>682</u> |
| B10. Indicate the source of the Base Flood Elevation (BFE) data or base flood depth entered in Item B9. <input type="checkbox"/> FIS Profile <input checked="" type="checkbox"/> FIRM <input type="checkbox"/> Community Determined <input type="checkbox"/> Other (Describe) _____ | | | | | |
| B11. Indicate elevation datum used for BFE in Item B9: <input checked="" type="checkbox"/> NGVD 1929 <input type="checkbox"/> NAVD 1988 <input type="checkbox"/> Other (Describe) _____ | | | | | |
| B12. Is the building located in a Coastal Barrier Resources System (CBRS) area or Otherwise Protected Area (OPA)? Designation Date _____ <input type="checkbox"/> CBRS <input type="checkbox"/> OPA <input type="checkbox"/> Yes <input checked="" type="checkbox"/> No | | | | | |

SECTION C - BUILDING ELEVATION INFORMATION (SURVEY REQUIRED)

C1. Building elevations are based on: Construction Drawings* Building Under Construction* Finished Construction

*A new Elevation Certificate will be required when construction of the building is complete.

C2. Elevations - Zones A1-A30, AE, AH, A (with BFE), VE, V1-V30, V (with BFE), AR, AR/A, AR/AE, AR/A1-A30, AR/AH, AR/AO. Complete Items C2.a-g below according to the building diagram specified in Item A7.

Benchmark Utilized BM 14: ELEV. = 682.09 WIRE SPIKE IN Vertical Datum NGVD 1929

Conversion/Comments LEAD TOP OF E. CURB OF HASKELL AVE., 55.7 FT. N/DN. CURB OF OTSEGO ST., ON THE SW COR OF THE CATCH BASIN, ESTABLISHED BY LACFD. PER FIRM 060137-0038. Check the measurement used.


| | | |
|---|--|--|
| a) Top of bottom floor (including basement, crawl space, or enclosure floor) | <u>684.23</u> <input checked="" type="checkbox"/> feet | <input type="checkbox"/> meters (Puerto Rico only) |
| b) Top of the next higher floor | <u>693.39</u> <input checked="" type="checkbox"/> feet | <input type="checkbox"/> meters (Puerto Rico only) |
| c) Bottom of the lowest horizontal structural member (V Zones only) | <u>-</u> <input type="checkbox"/> feet | <input type="checkbox"/> meters (Puerto Rico only) |
| d) Attached garage (top of slab) | <u>684.73</u> <input type="checkbox"/> feet | <input type="checkbox"/> meters (Puerto Rico only) |
| e) Lowest elevation of machinery or equipment servicing the building (Describe type of equipment in Comments) | <u>-</u> <input type="checkbox"/> feet | <input type="checkbox"/> meters (Puerto Rico only) |
| f) Lowest adjacent (finished) grade (LAG) | <u>682.89</u> <input checked="" type="checkbox"/> feet | <input type="checkbox"/> meters (Puerto Rico only) |
| g) Highest adjacent (finished) grade (HAG) | <u>683.09</u> <input checked="" type="checkbox"/> feet | <input type="checkbox"/> meters (Puerto Rico only) |

SECTION D - SURVEYOR, ENGINEER, OR ARCHITECT CERTIFICATION

This certification is to be signed and sealed by a land surveyor, engineer, or architect authorized by law to certify elevation information. I certify that the information on this Certificate represents my best efforts to interpret the data available. I understand that any false statement may be punishable by fine or imprisonment under 18 U.S. Code, Section 1001.

Check here if comments are provided on back of form.

| | |
|---|------------------------------------|
| Certifier's Name <u>CHARLES M. MATHEWS</u> | License Number <u>L.S. 3585</u> |
| Title <u>LICENSED SURVEYOR</u> | Company Name |
| Address <u>10449 HAYVENHURST AVE</u> | City <u>GRANADA HILLS</u> |
| State <u>CA</u> | ZIP Code <u>91344</u> |
| Signature <u>Charles M. Mathews</u> | Date <u>4/14/09</u> |
| Telephone <u>(818) 360-5897</u> | |

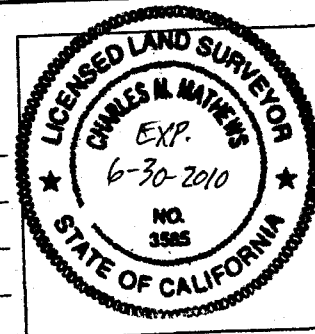

| | | |
|--|-------------|----------------------------|
| IMPORTANT: In these spaces, copy the corresponding information from Section A. | | For Insurance Company Use: |
| Building Street Address (including Apt., Unit, Suite, and/or Bldg. No.) or P.O. Route and Box No. 5113 HASKELL AVE. | | Policy Number |
| City LOS ANGELES | State CA | ZIP Code 91436 |
| | | Company NAIC Number |

SECTION D - SURVEYOR, ENGINEER, OR ARCHITECT CERTIFICATION (CONTINUED)

Copy both sides of this Elevation Certificate for (1) community official, (2) insurance agent/company, and (3) building owner.

Comments

Signature *Elizabeth M. Ang* Date 4/14/09 Check here if attachments

SECTION E - BUILDING ELEVATION INFORMATION (SURVEY NOT REQUIRED) FOR ZONE AO AND ZONE A (WITHOUT BFE)

For Zones AO and A (without BFE), complete Items E1-E5. If the Certificate is intended to support a LOMA or LOMR-F request, complete Sections A, B, and C. For Items E1-E4, use natural grade, if available. Check the measurement used. In Puerto Rico only, enter meters.

- E1. Provide elevation information for the following and check the appropriate boxes to show whether the elevation is above or below the highest adjacent grade (HAG) and the lowest adjacent grade (LAG):
 a) Top of bottom floor (including basement, crawl space, or enclosure) is 1.14 feet meters above or below the HAG.
 b) Top of bottom floor (including basement, crawl space, or enclosure) is 1.34 feet meters above or below the LAG.
- E2. For Building Diagrams 6-8 with permanent flood openings provided in Section A Items 8 and/or 9 (see page 8 of Instructions), the next higher floor (elevation C2.b in the diagrams) of the building is feet meters above or below the HAG.
- E3. Attached garage (top of slab) is 1.14 feet meters above or below the HAG.
- E4. Top of platform of machinery and/or equipment servicing the building is feet meters above or below the HAG.
- E5. Zone AO only: If no flood depth number is available, is the top of the bottom floor elevated in accordance with the community's floodplain management ordinance? Yes No Unknown. The local official must certify this information in Section G.

SECTION F - PROPERTY OWNER (OR OWNER'S REPRESENTATIVE) CERTIFICATION

The property owner or owner's authorized representative who completes Sections A, B, and E for Zone A (without a FEMA-issued or community-issued BFE) or Zone AO must sign here. The statements in Sections A, B, and E are correct to the best of my knowledge.

Property Owner's or Owner's Authorized Representative's Name
ELIZABETH ANG

Address 5113 HASKELL AVE City LOS ANGELES State CA ZIP Code 91436

Signature *Elizabeth Ang* Date 4/16/09 Telephone 818 907 7215

Comments

Check here if attachments

SECTION G - COMMUNITY INFORMATION (OPTIONAL)

The local official who is authorized by law or ordinance to administer the community's floodplain management ordinance can complete Sections A, B, C (or E), and G of this Elevation Certificate. Complete the applicable item(s) and sign below. Check the measurement used in Items G8. and G9.

- G1. The information in Section C was taken from other documentation that has been signed and sealed by a licensed surveyor, engineer, or architect who is authorized by law to certify elevation information. (Indicate the source and date of the elevation data in the Comments area below.)
- G2. A community official completed Section E for a building located in Zone A (without a FEMA-issued or community-issued BFE) or Zone AO.
- G3. The following information (Items G4.-G9.) is provided for community floodplain management purposes.

| | | |
|-------------------|------------------------|---|
| G4. Permit Number | G5. Date Permit Issued | G6. Date Certificate Of Compliance/Occupancy Issued |
|-------------------|------------------------|---|


G7. This permit has been issued for: New Construction Substantial Improvement

G8. Elevation of as-built lowest floor (including basement) of the building: feet meters (PR) Datum

G9. BFE or (in Zone AO) depth of flooding at the building site: feet meters (PR) Datum


| | | |
|-----------------------|--|-----------|
| Local Official's Name | Bureau of Engineering | Title |
| Community Name | Stormwater Group | Telephone |
| Signature | Elevation Certificate Review | Date |
| Comments | Permit No. <u>07010-20000-03330</u> | |
| | <input checked="" type="checkbox"/> Approved By: <u>CP</u> | |
| | Date: <u>4/29/09</u> | |

Check here if attachments

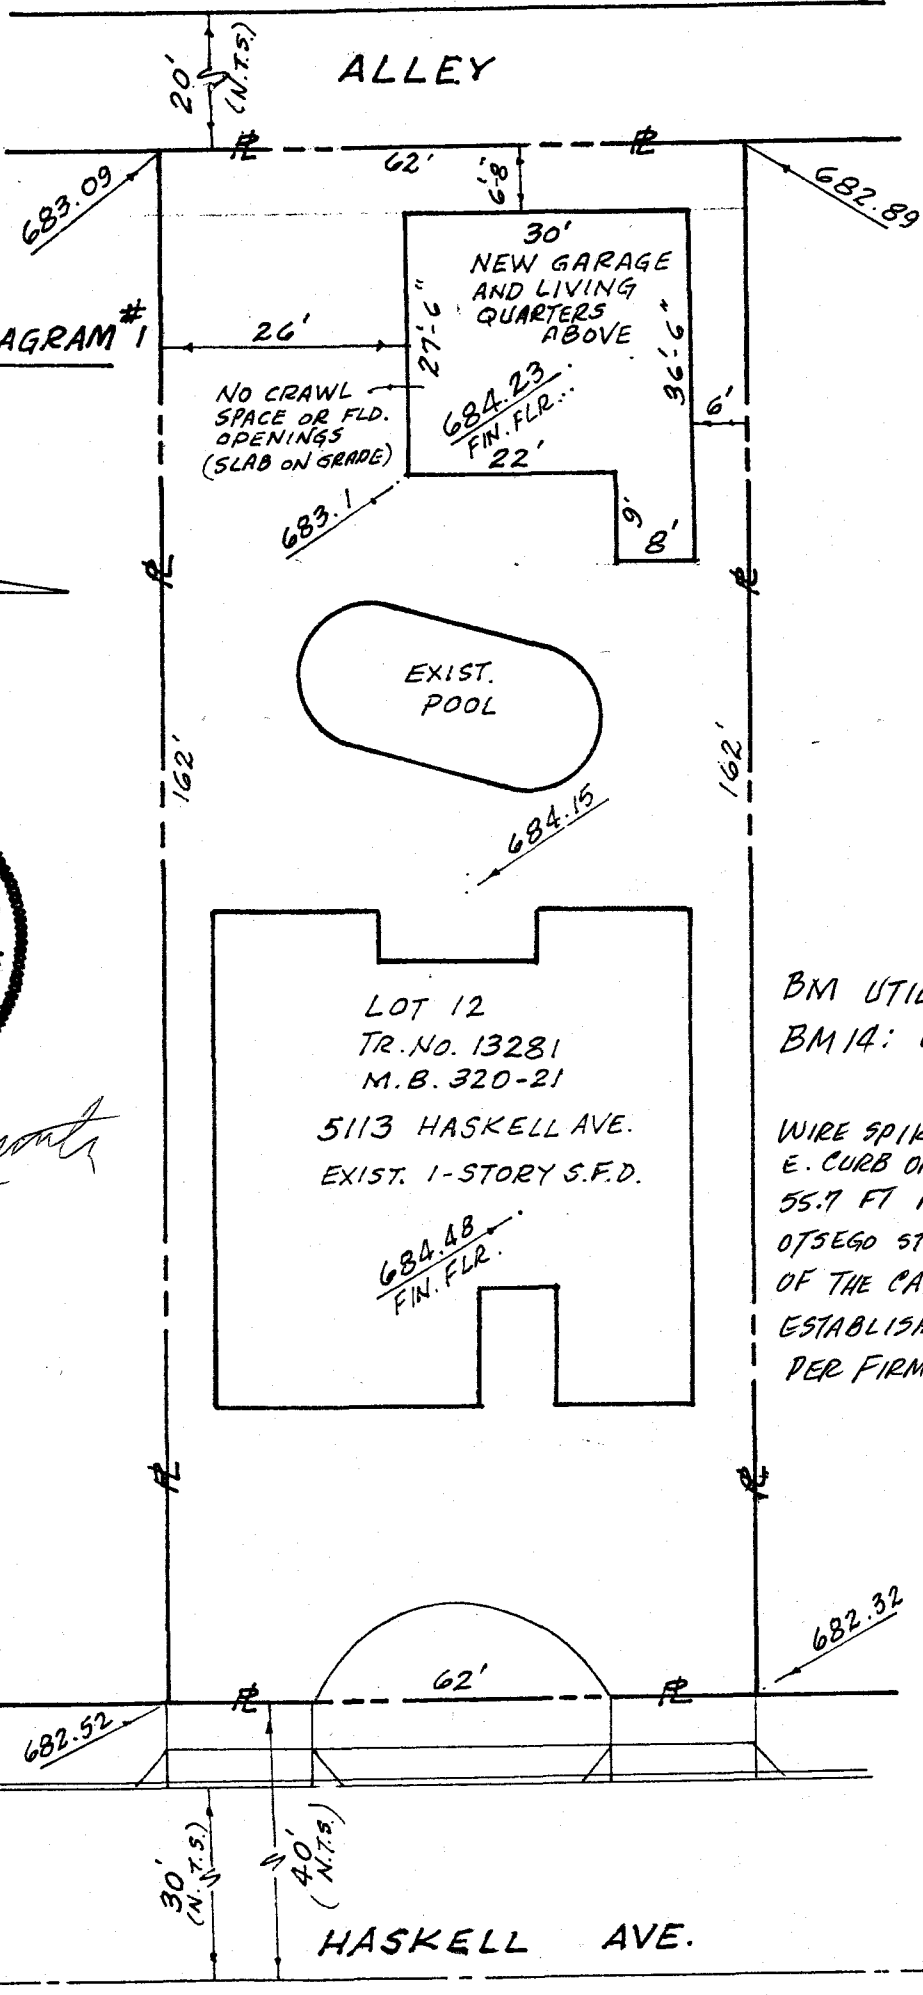

BUILDING DIAGRAM #1

SCALE: 1" = 20'

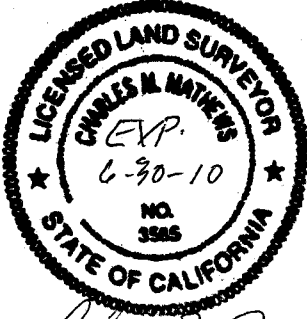

Charles M. Mathews
 C.S. 3585
 4/14/09

LOT 12
 TR. NO. 13281
 M.B. 320-21
 5113 HASKELL AVE.
 EXIST. 1-STORY S.F.D.

BM UTILIZED:
 BM 14: ELEV = 682.09
 NGVD 1929
 WIRE SPIKE IN LEAD, TOP OF
 E. CURB OF HASKELL AVE.,
 55.7 FT N/O N. CURB OF
 OTSEGO ST., ON THE SW COR.
 OF THE CATCH BASIN,
 ESTABLISHED BY LACFCD.,
 PER FIRM 060137-0038.

Building Photographs

Continuation Page

| | | | | |
|---|-------|----------|----------------------------|--|
| Building Street Address (including Apt., Unit, Suite, and/or Bldg. No.) or P.O. Route and Box No. | | | For Insurance Company Use: | |
| 5113 HASKELL AVE | | | Policy Number | |
| City | State | ZIP Code | Company NAIC Number | |
| LOS ANGELES | CA | 91436 | | |

If submitting more photographs than will fit on the preceding page, affix the additional photographs below. Identify all photographs with: date taken; "Front View" and "Rear View"; and, if required, "Right Side View" and "Left Side View."

